

D

C

B


A

D


C

B


A

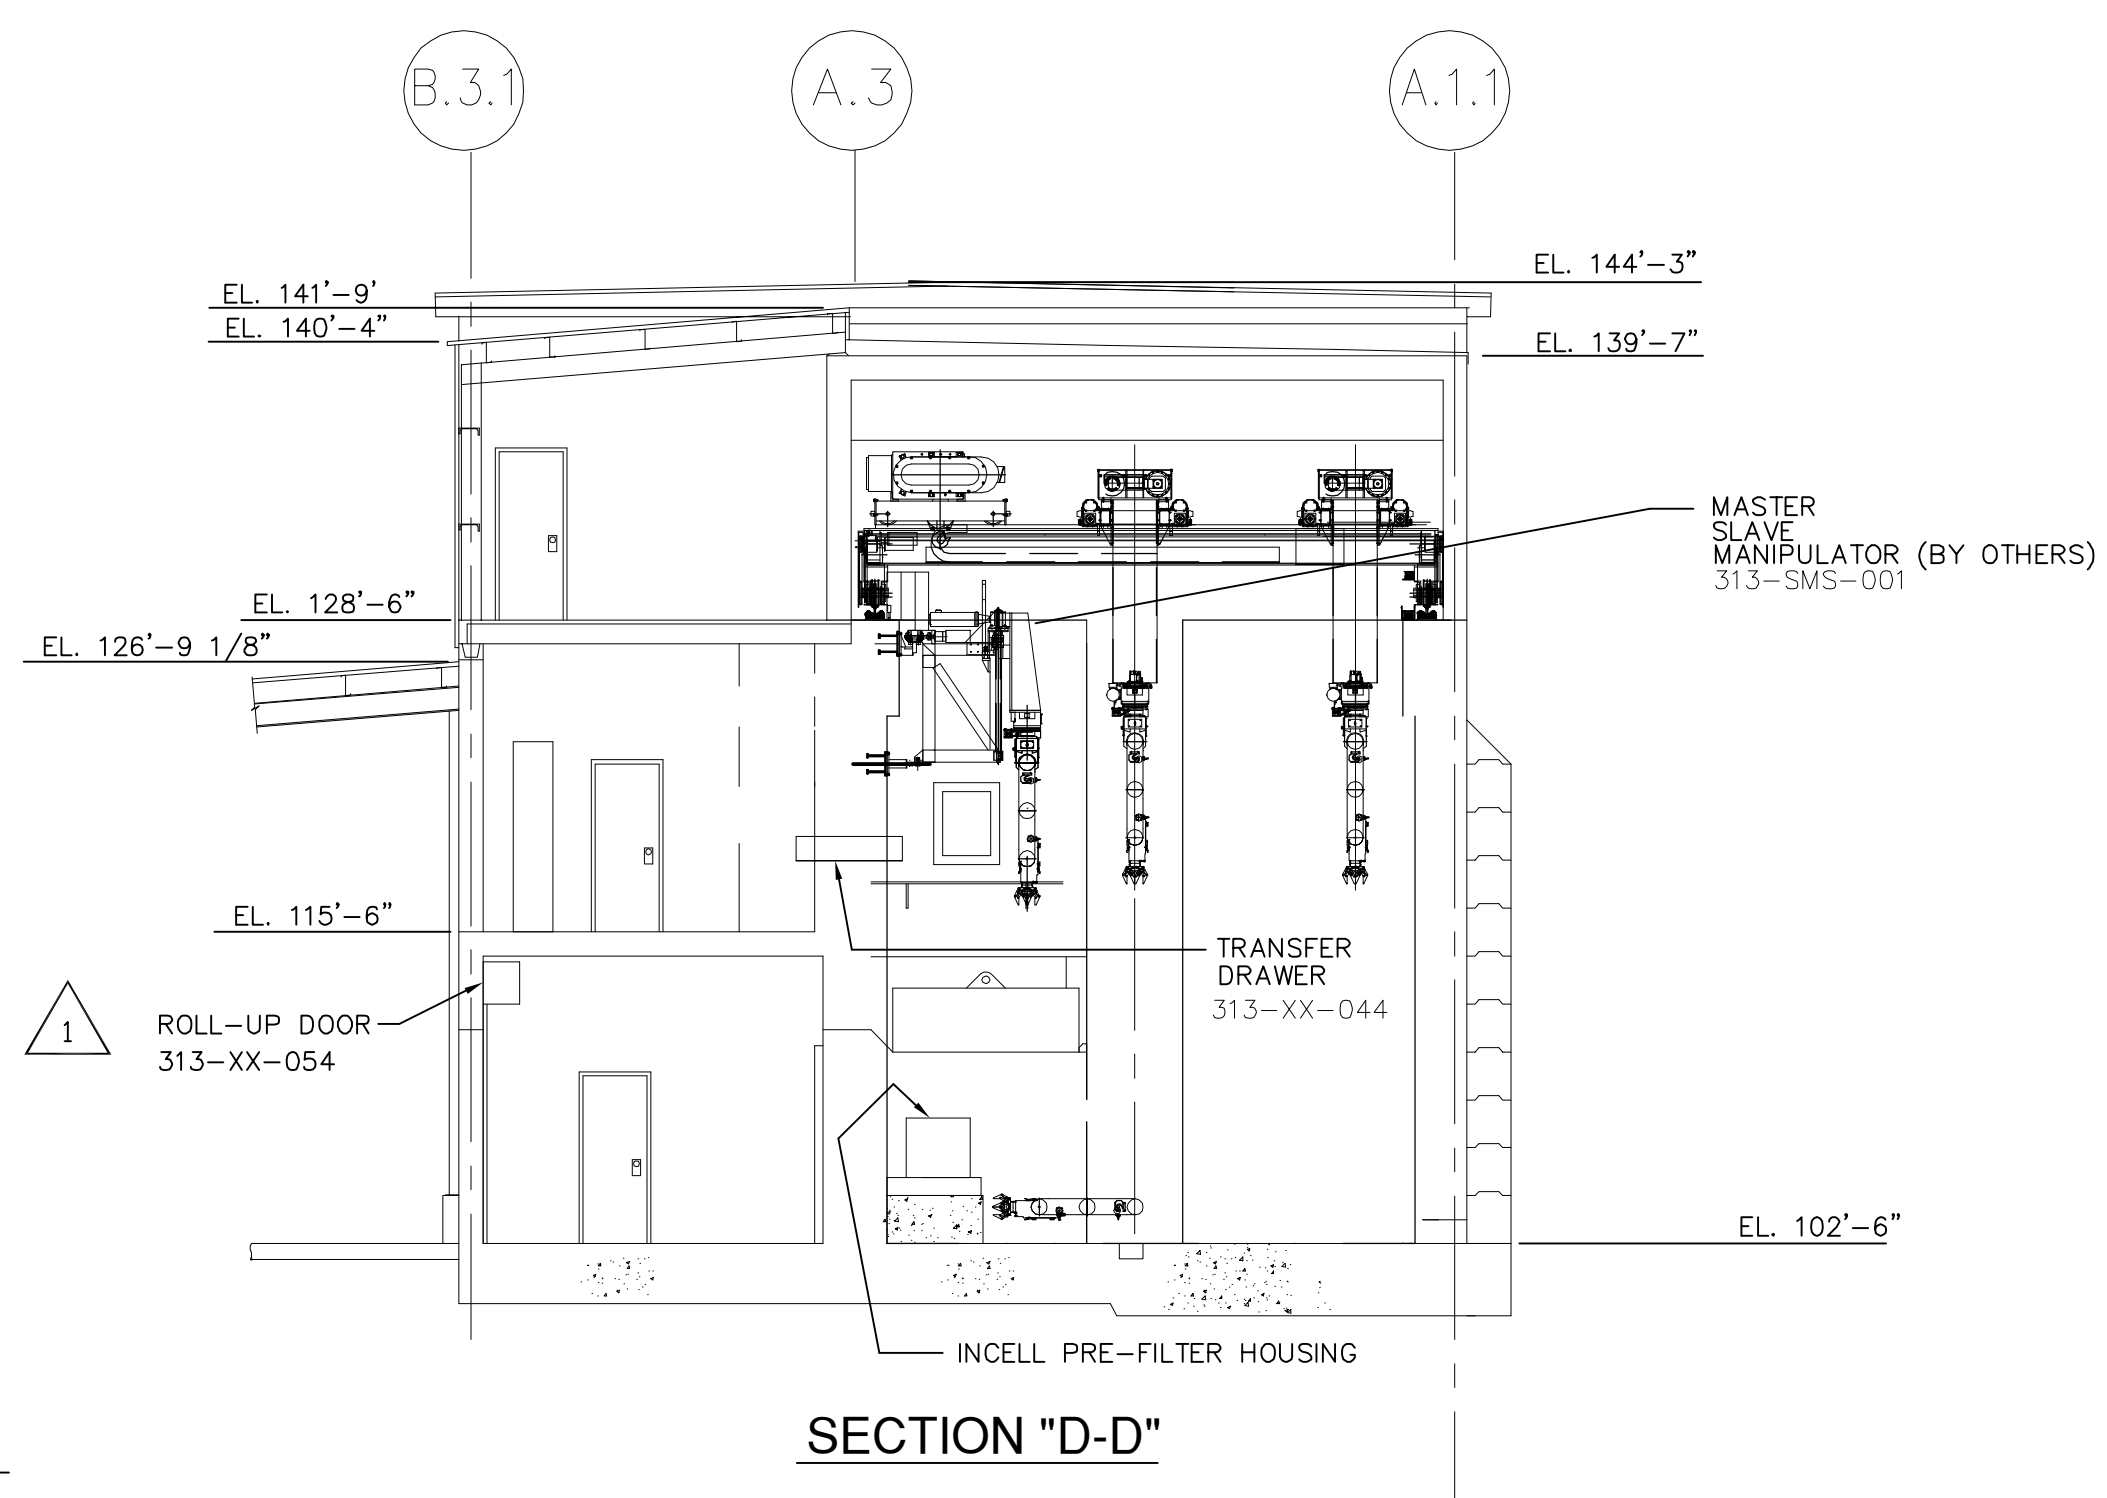

SECTION "D-D"

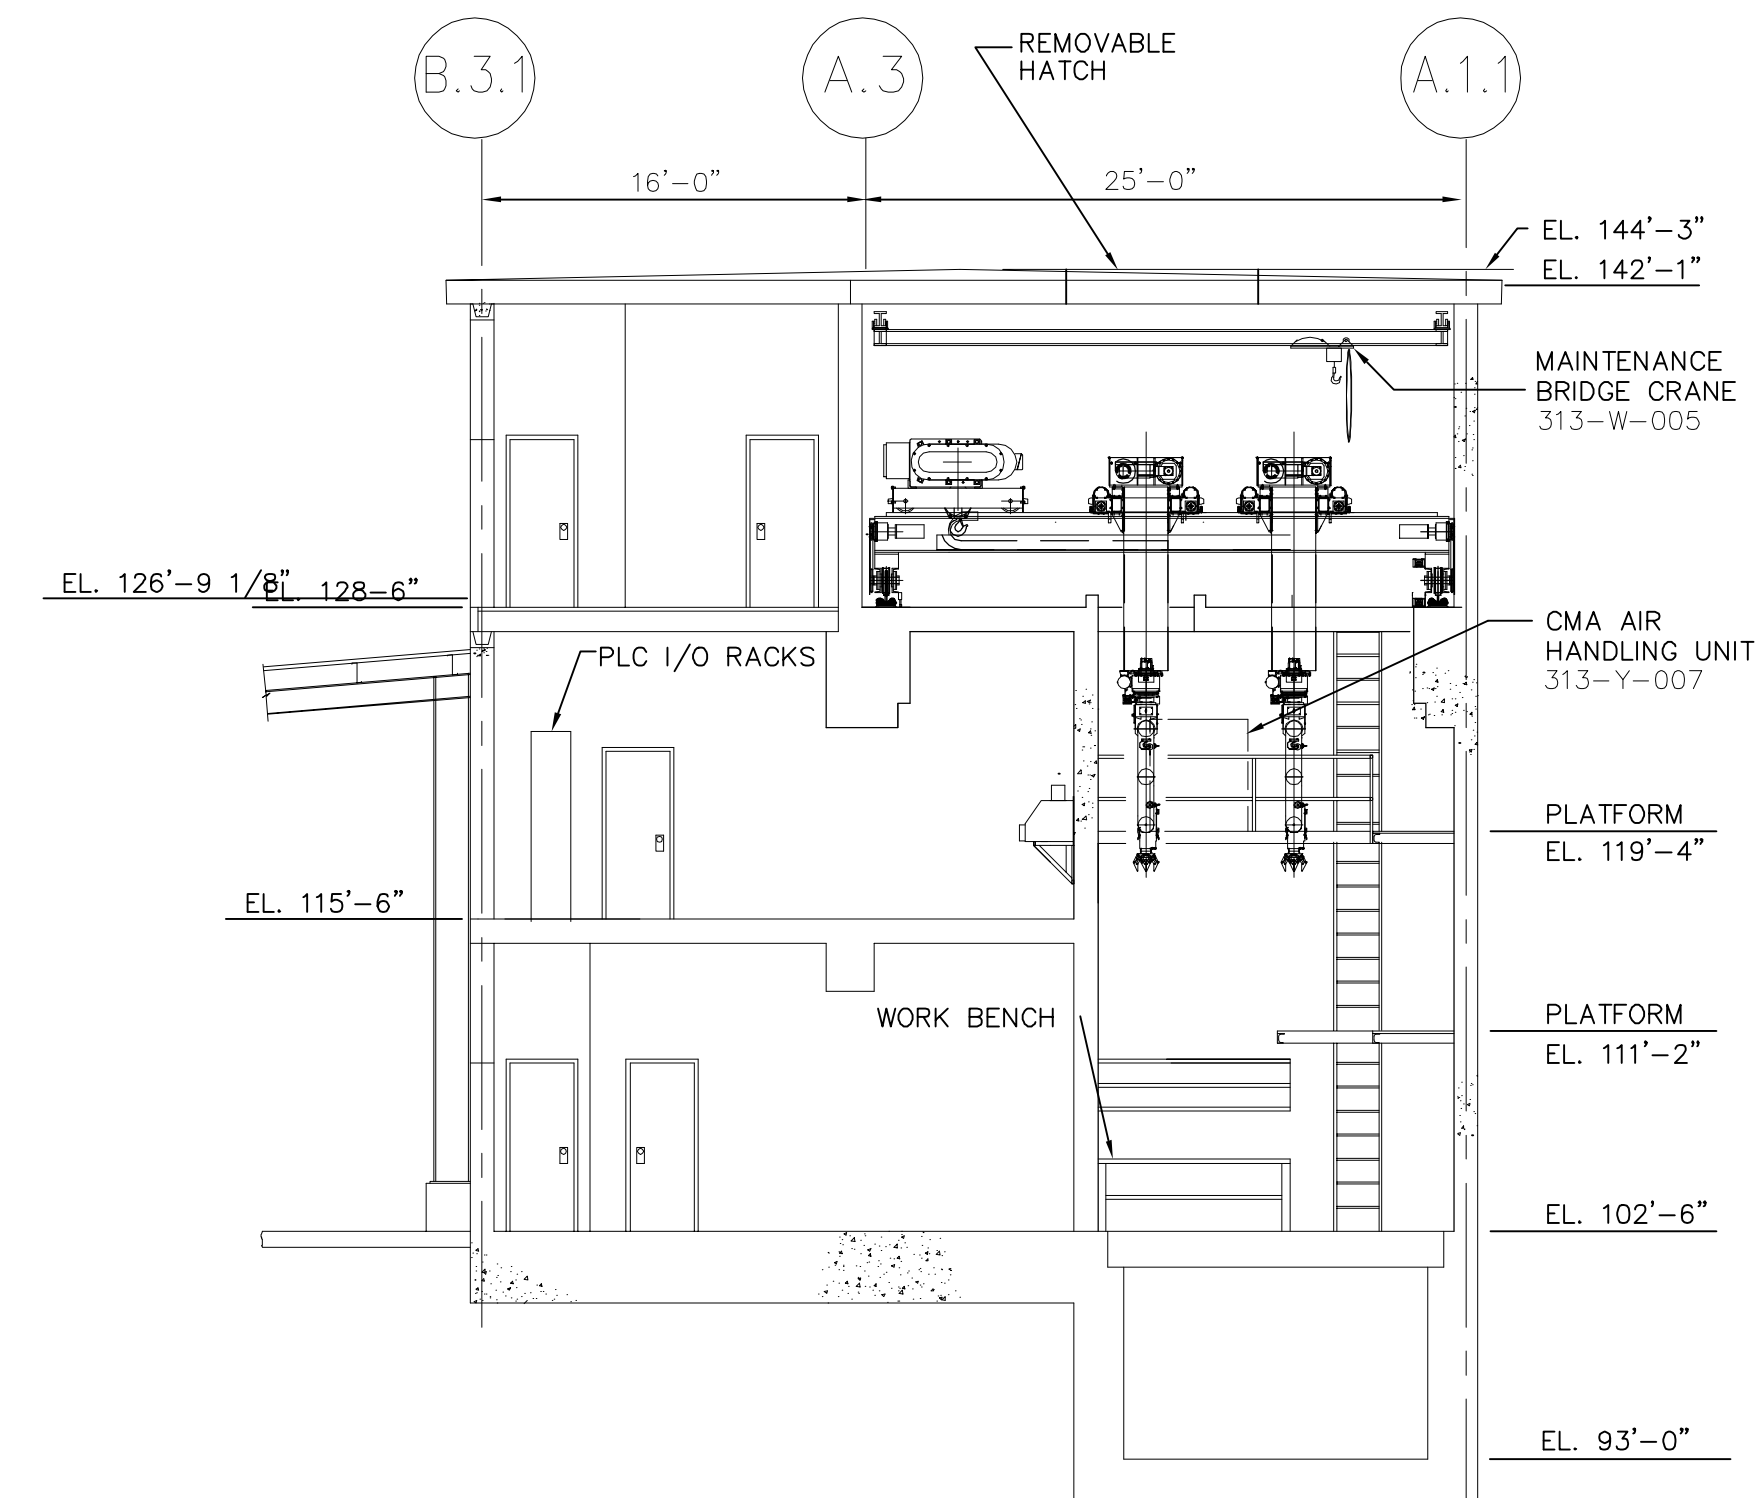

SECTION "E-E"

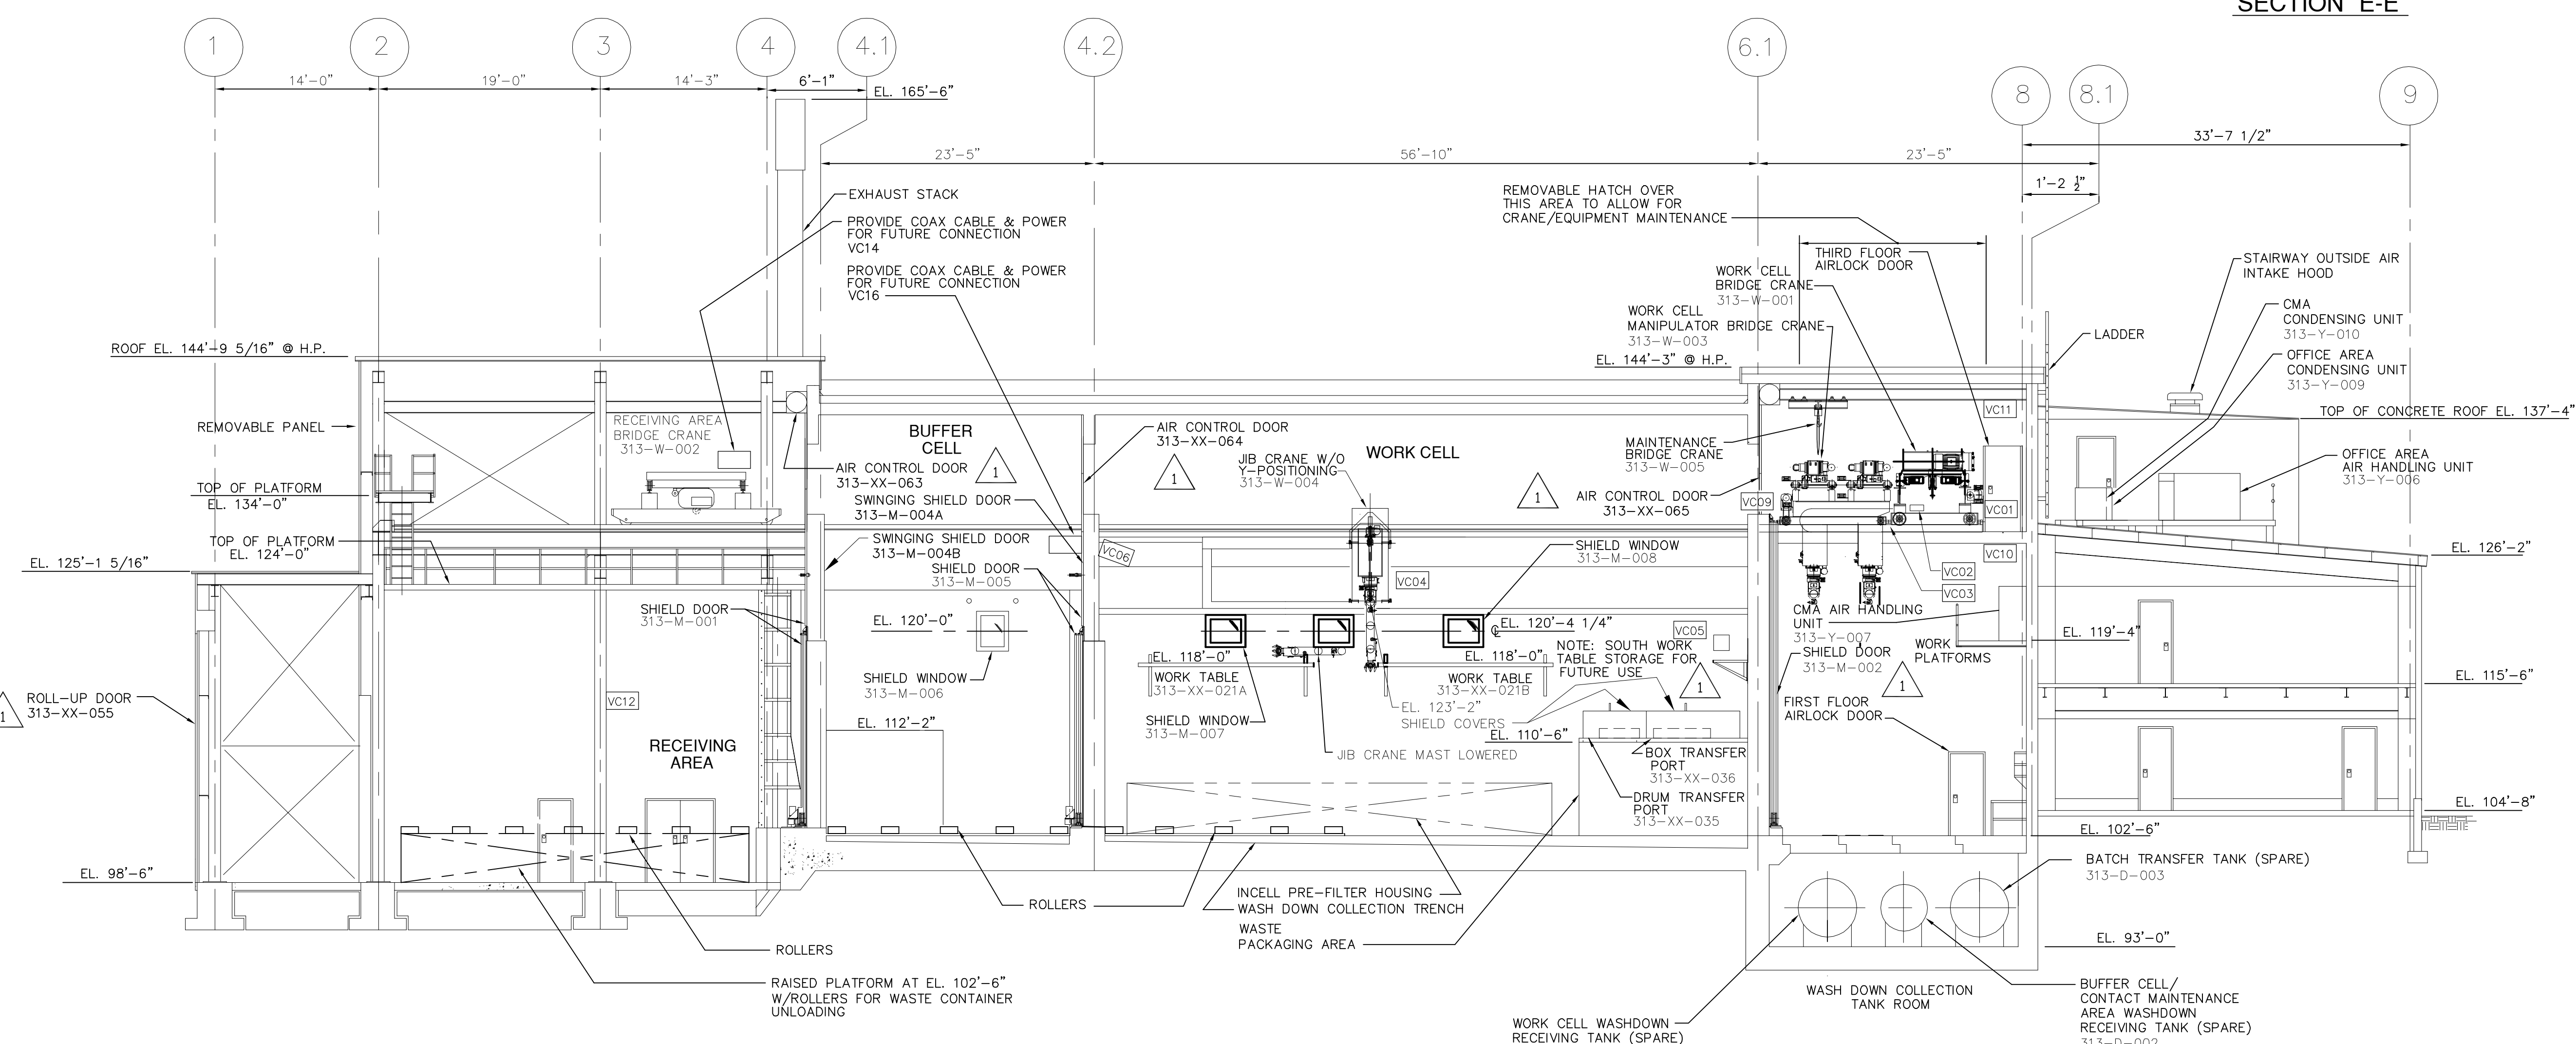

SECTION "A-A"

AS BUILT

VERIFY ALL DOCUMENTS FOR  
CURRENT REVISION AND PENDING  
CHANGES PRIOR TO EACH USE  
INIT \_\_\_\_\_ DATE \_\_\_\_\_

REVISIONS			
REV	DESCRIPTION	APVD	DATE
1	INCORPORATE THE FOLLOWING DONS: 051, 058, 059, 060, 062, 063, 065, 066, 067, 070, 071, 073 & 076.	MG/146	08/22/01 AWU WC EO 5/24/01
2	FDR ACTION/ITEM CHIT RESOLUTION. GENERAL REVISION AS CIRCLED.	WN	04/22/01 WC 08/22/01 EO 08/22/01
3	GENERAL REVISION AS CIRCLED.	LC	01/16/03 WC EO
4	INCORPORATED: FCN-023, FCN-157.	WN	01/16/03 WC EO 12/22/04
0	ER 25966 04/23/2004	CCG	
1	ECN 25963 HAB 04/29/2004	HAB	

UNLESS OTHERWISE SPECIFIED ALL DIMENSIONS IN INCHES		DRAWER VENDOR	DATE
FILE NAME 911-D_030_004_000		CHECKER VENDOR	DATE
PLOT SCALE 1=96.00		ENGINEER VENDOR	DATE
D SPEC # 0000	DATABASE LINKED DRAWING	DWG #	REV
NEXT ASSEMBLY	SEE ENGINEERING RELEASE FORM (ERO) FOR DRAWING APPROVAL SIGNATURES.	911-D-030	1
A/E CONTRACT #		DWG IDENT #	

VENDOR: BUTLER CONSTRUCTION CO. OF WNY, INC.  
RAYTHEON NUCLEAR, INC.  
rnr

**WVNSCO**  
West Valley Nuclear Services Company

RHW  
GENERAL ARRANGEMENT  
SECTIONS A-A, D-D AND E-E